Cache County

Monument Record Sheet

Cache County Corner ID # **1175**

BLM Point Name	Contact Name	License Number	Date
UT260100N0010E0_600100	Jeff C. Nielsen	5152661	4/17/2024

Corner of Section
600100

Township and Range
T10N R1E / T9N R1E

Base and Meridian
Salt Lake

State	County
UT	Cache County

Geographic Coordinates

Latitude (DMS)	N41°33'13.71393"
Longitude (DMS)	W111°47'38.46797"
Ellipsoid Height	

Grid Coordinates

Northing	3725640.3204
Easting	1559943.2218
Horizontal Units	feet
Ortho Elevation	5436.2552

Coordinate System	Zone
NAD83 State Plane	UT North


Datum
WGS84

Vertical Units
12A

Vertical Datum
NAVD88

Monument Status
Existing

Section Corner Location

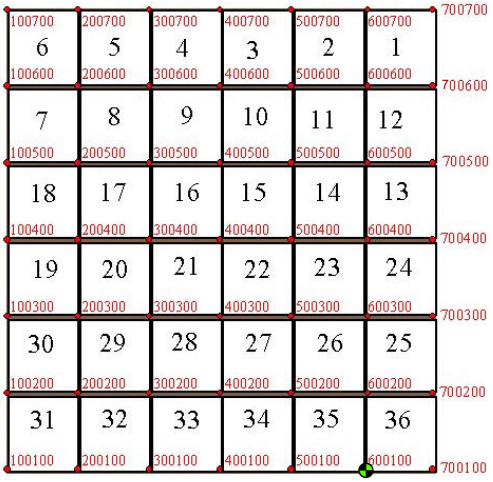

Map View Photo or Sketch



Monument Area Photo



Monument Close-up Photo



Additional Notes

Reference Points

1 3725650.8192 1559944.8655 RP1 R/C CCS
2 3725637.8549 1559929.4417 RP2 R/C CCS
3 3725616.8734 1559943.1928 RP3 R/C CCS

REGISTERED LAND SURVEYOR 5152661 JEFF C. NIELSEN STATE OF UTAH

Monument Description

Set 2.5" alum CC survey cap on fence corner headed NW. Set RP1,RP2,RP3, 5/8" rebar w/ CC survey cap


Cache County makes no guarantees, representations, or warranties of any kind, expresss or implied, as to the content, accuracy, timeliness, or completeness of any of the data. Cache County reserves the right to make changes to the data at anytime without notice.

Type of Corner: ☒Section ☐Quarter ☐Witness ☐Accessory ☐Property ☐Bench Mark ☐Right of Way

Condition of Corner: ☒Good ☐Damaged ☐Missing ☐Re-established ☐Needs Repair

Monument Description: (Describe materials, location, accessibility, etc. Be Specific)
SET 2½" ALUM. CACHE COUNTY SURVEY CAP ON FENCE CORNER HEADED NORTH/WEST

TOWNSHIP	RANGE	SECTION
10N, 9N	1E	1, 2, 35, 36

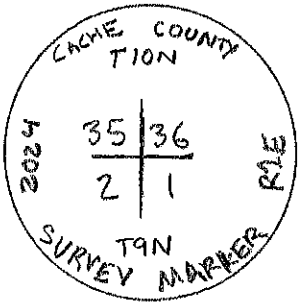


SECTION CORNER # 1175 **DATE:** 04-17-24

CREW MEMBERS: TYLER ZORN, COLTON DRANEY

FIELD NOTES:

SET 2½ ALUM CACHE COUNTY
SURVEY CAP

SET RP1 5/8" RBR W/ CACHE COUNTY
SURVEY CAP
" RP2. RP3"

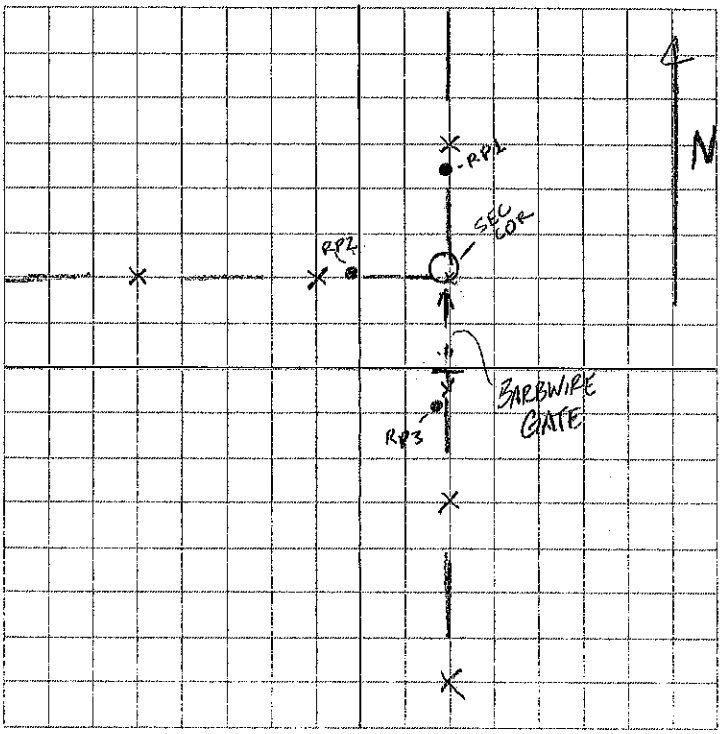


CACHE COUNTY
T10N
35 36
2 1
T9N
SURVEY MARKER
2024
R1E


NO
TRESPASSING
CALDWEED RANCH

